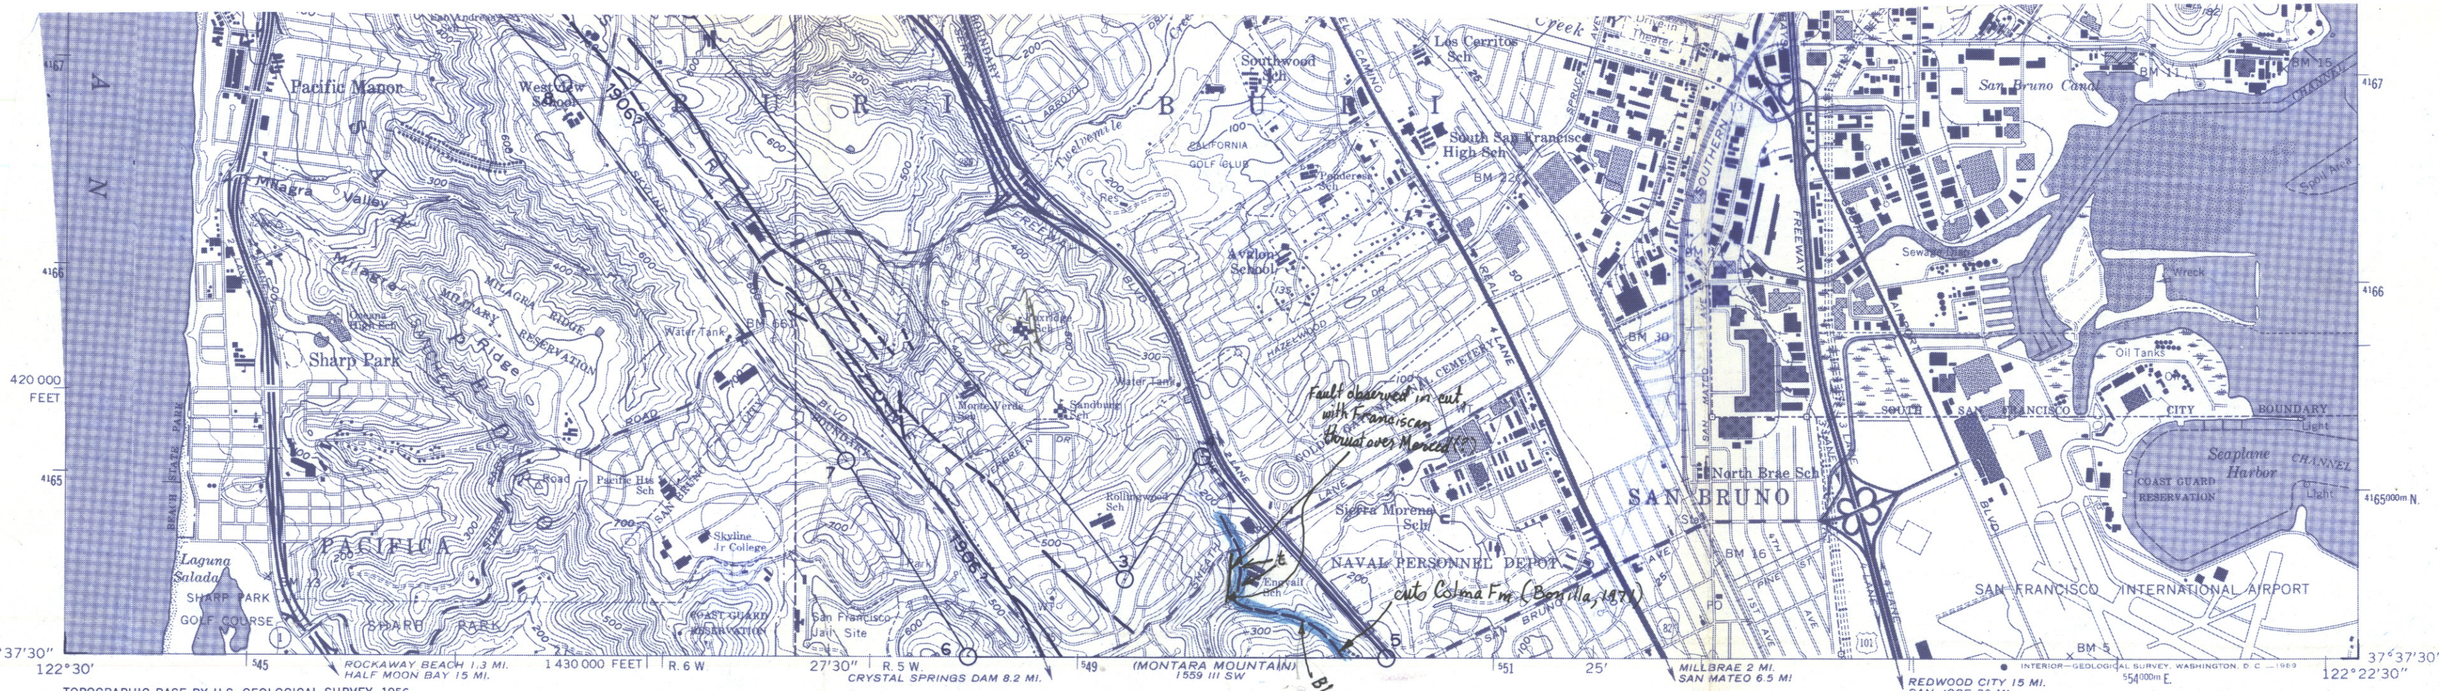

TOPOGRAPHIC BASE BY U.S. GEOLOGICAL SURVEY 1956
PHOTOREVISED 1968

SCALE 1:24000

1 0 1 MILE
1000 0 1000 2000 3000 4000 5000 6000 7000 FEET
1 5 0 1 KILOMETER

FER-119, Figure 2B. Official Special Studies Zones map of 1974.

MAP EXPLANATION

Potentially Active Faults

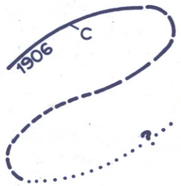

Faults considered to have been active during Quaternary time; solid line where accurately located, long dash where approximately located, short dash where inferred, dotted where concealed; query (?) indicates additional uncertainty. Evidence of historic offset indicated by year of earthquake-associated event or C for displacement caused by creep or possible creep.

Aerial photo lineaments (not field checked); based on youthful geomorphic and other features believed to be the results of Quaternary faulting.

Special Studies Zone Boundaries

These are delineated as straight-line segments that connect consecutively numbered turning points so as to define one or more special studies zone segments.

OFFICIAL MAP

Effective: July 1, 1974

STATE OF CALIFORNIA

SPECIAL STUDIES ZONES

Delineated in compliance with Chapter 7.5, Division 2 of the California Public Resources Code

SAN FRANCISCO SOUTH QUADRANGLE

~~IMPORTANT — PLEASE NOTE~~

1) ~~These~~ REFERENCES USED TO COMPILE FAULT DATA

San Francisco South Quadrangle

Bonilla, M.G., 1971, Preliminary geologic map of the San Francisco South quadrangle and part of the Hunters Point quadrangle, California: U.S. Geological Survey Basic Data Contribution 29, San Francisco Bay Region Environment and Resources Planning Study.

Brown, R.D., Jr., 1972, Active faults, probable active faults, and associated fracture zones, San Mateo County, California: U.S. Geological Survey Basic Data Contribution 44, San Francisco Bay Region Environment and Resources Planning Study.

Cooper, Alan, 1971, Structure of the continental shelf west of San Francisco, California: California State University at San Jose, M.S. thesis.

Schlocker, J., Pampeyan, E.H., and Bonilla, M.G., 1965, Approximate trace of the main surface rupture in the San Andreas fault zone between Pacifica and Saratoga, California, formed during the earthquake of April 18, 1906: U.S. Geological Survey open-file report.

~~the Public Resources Code.~~

119-1